

N ATTICS, ALL OTHER

ATION REQUIREMENTS  
CURRENT 2010 ENERGY  
. PER SECTION 402.2.3,  
D TO LEVEL EQUIVALENT  
ES SHALL BE PROVIDED TO  
LE SPACE.

REVIEWED UNDER MY  
SE, BELIEF, AND  
ONS ARE IN COMPLIANCE  
ONSTRUCTION CODE.

MENTS AND  
ATE RESIDENTIAL  
ERVATION CODE OF

XIDE


G RESIDENCE

T CURRENT NYS

-18-2012 (AS-BUILT)  
-16-2012

*9/6/12*  
*[Signature]*

Seal:

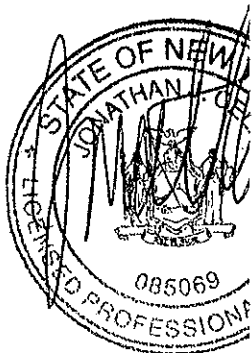

Designer/ Engineer:

Jonathan Cella, P.E.  
55 Scofield Street  
Walden, New York, 12586  
(845) 778-0697  
N.Y.S. P.E. License #: 085069

Date:

10/8/2011

Sheet Number:

A-1

2" X 10"

VENT

1 1/2"

2"

1 1/2"

1 1/2"

1 1/2"

SIZE AND DRAIN SIZE,

24414-12

CODE COMPLIANCE DEPT.

SEP 06 2012

Sign X

OR ALTERATIONS TO  
TS FOR A NEW  
ING SYSTEM TO COMPLY  
ERATIONS SHALL NOT  
Y OR OVERLOADED.

RATING, 5/8" FIRE  
USE. DOOR INTO HOUSE

ROVIDE MINIMUM FRESH  
TURER.

VENT AIR SEAPAGE OR

INGS, VAPOR RETARDERS

Project Title:

AL MCQUIRE ADDITION

S-B-L: 73-5-21.1


144 TAFT AVENUE

TOWN OF NEWBURGH, NY

SB  
6

Sheet Title:


PHOTOS OF EXISTING &  
GENERAL CONSTRUCTION  
DRAWING NOTES

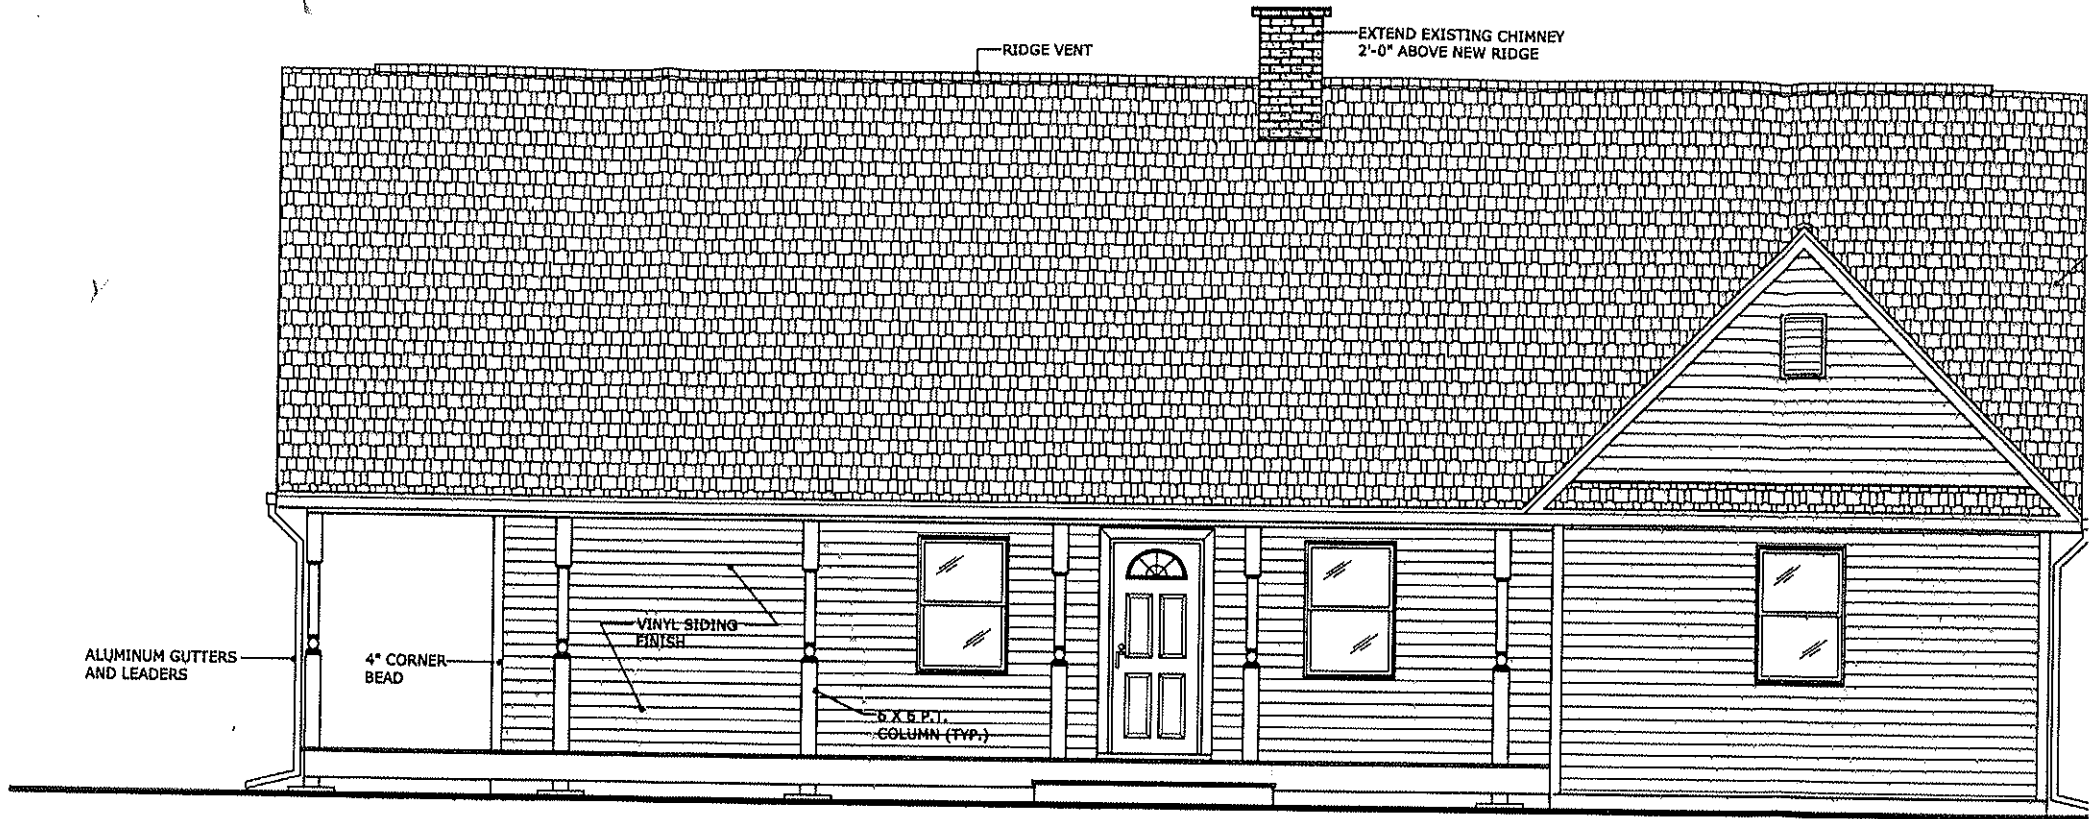


## PROPOSED FRONT ELEVATION

Scale: 1/4" = 1'-0"

NEW 2 X 10 COLLAR TIES AT 16" O.C.,  
2/3RDS DISTANCE FROM JOISTS TO  
RIDGE (TYP., UNLESS NOTED  
OTHERWISE)

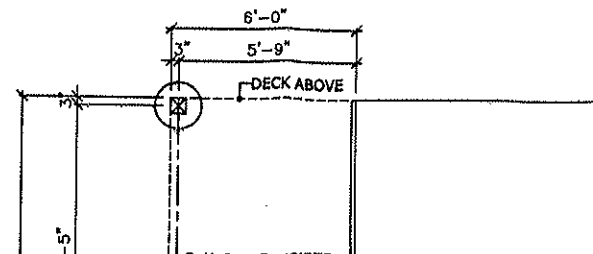

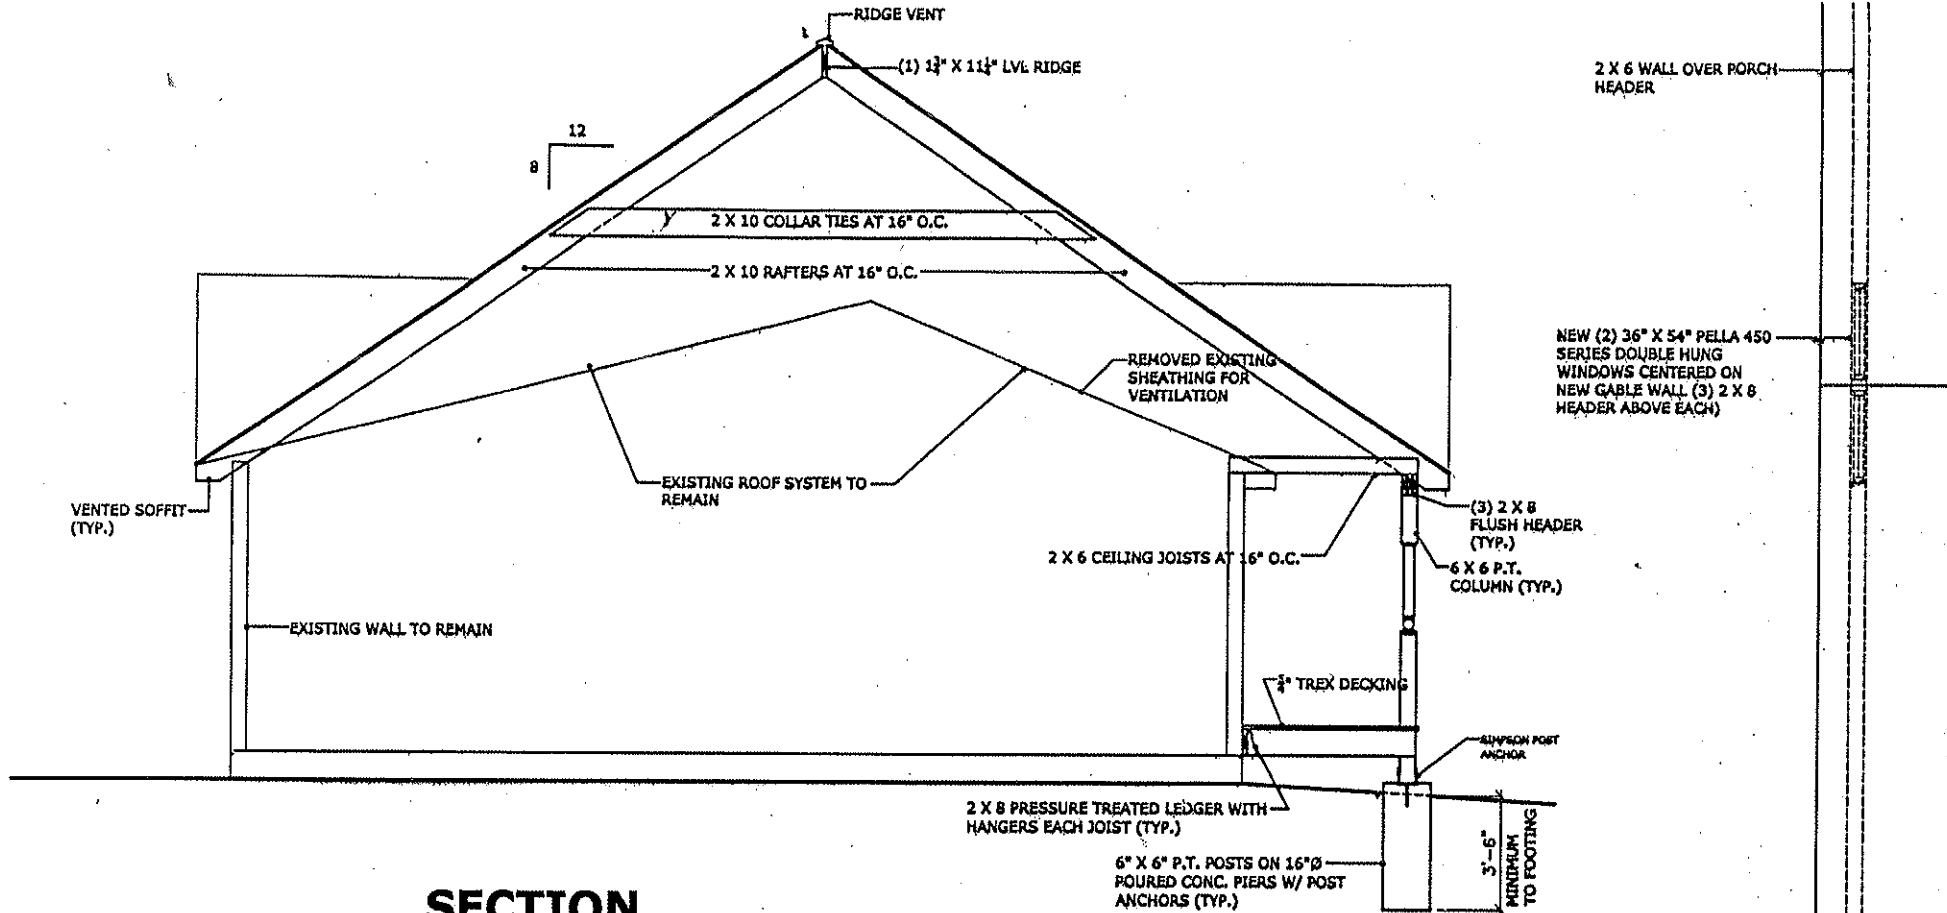

**SECTION**

Scale: 1/4" = 1'-0"

NOTE: FRAME NEW ROOF OVER EXISTING ROOF

**ROOF PLAN**

Scale: 1/4" = 1'-0"


NOTE: SKYLIGHTS SHALL BE REINSTALLED BY MANUFACTURER. SKYLIGHT SHOOT WALL

...D WITH R-21 INSULATION.

PLANS REVISED 8-18-2012 (AS-BUILT)  
 PLANS REVISED 5-16-2012

Sheet Number:

**A-3**

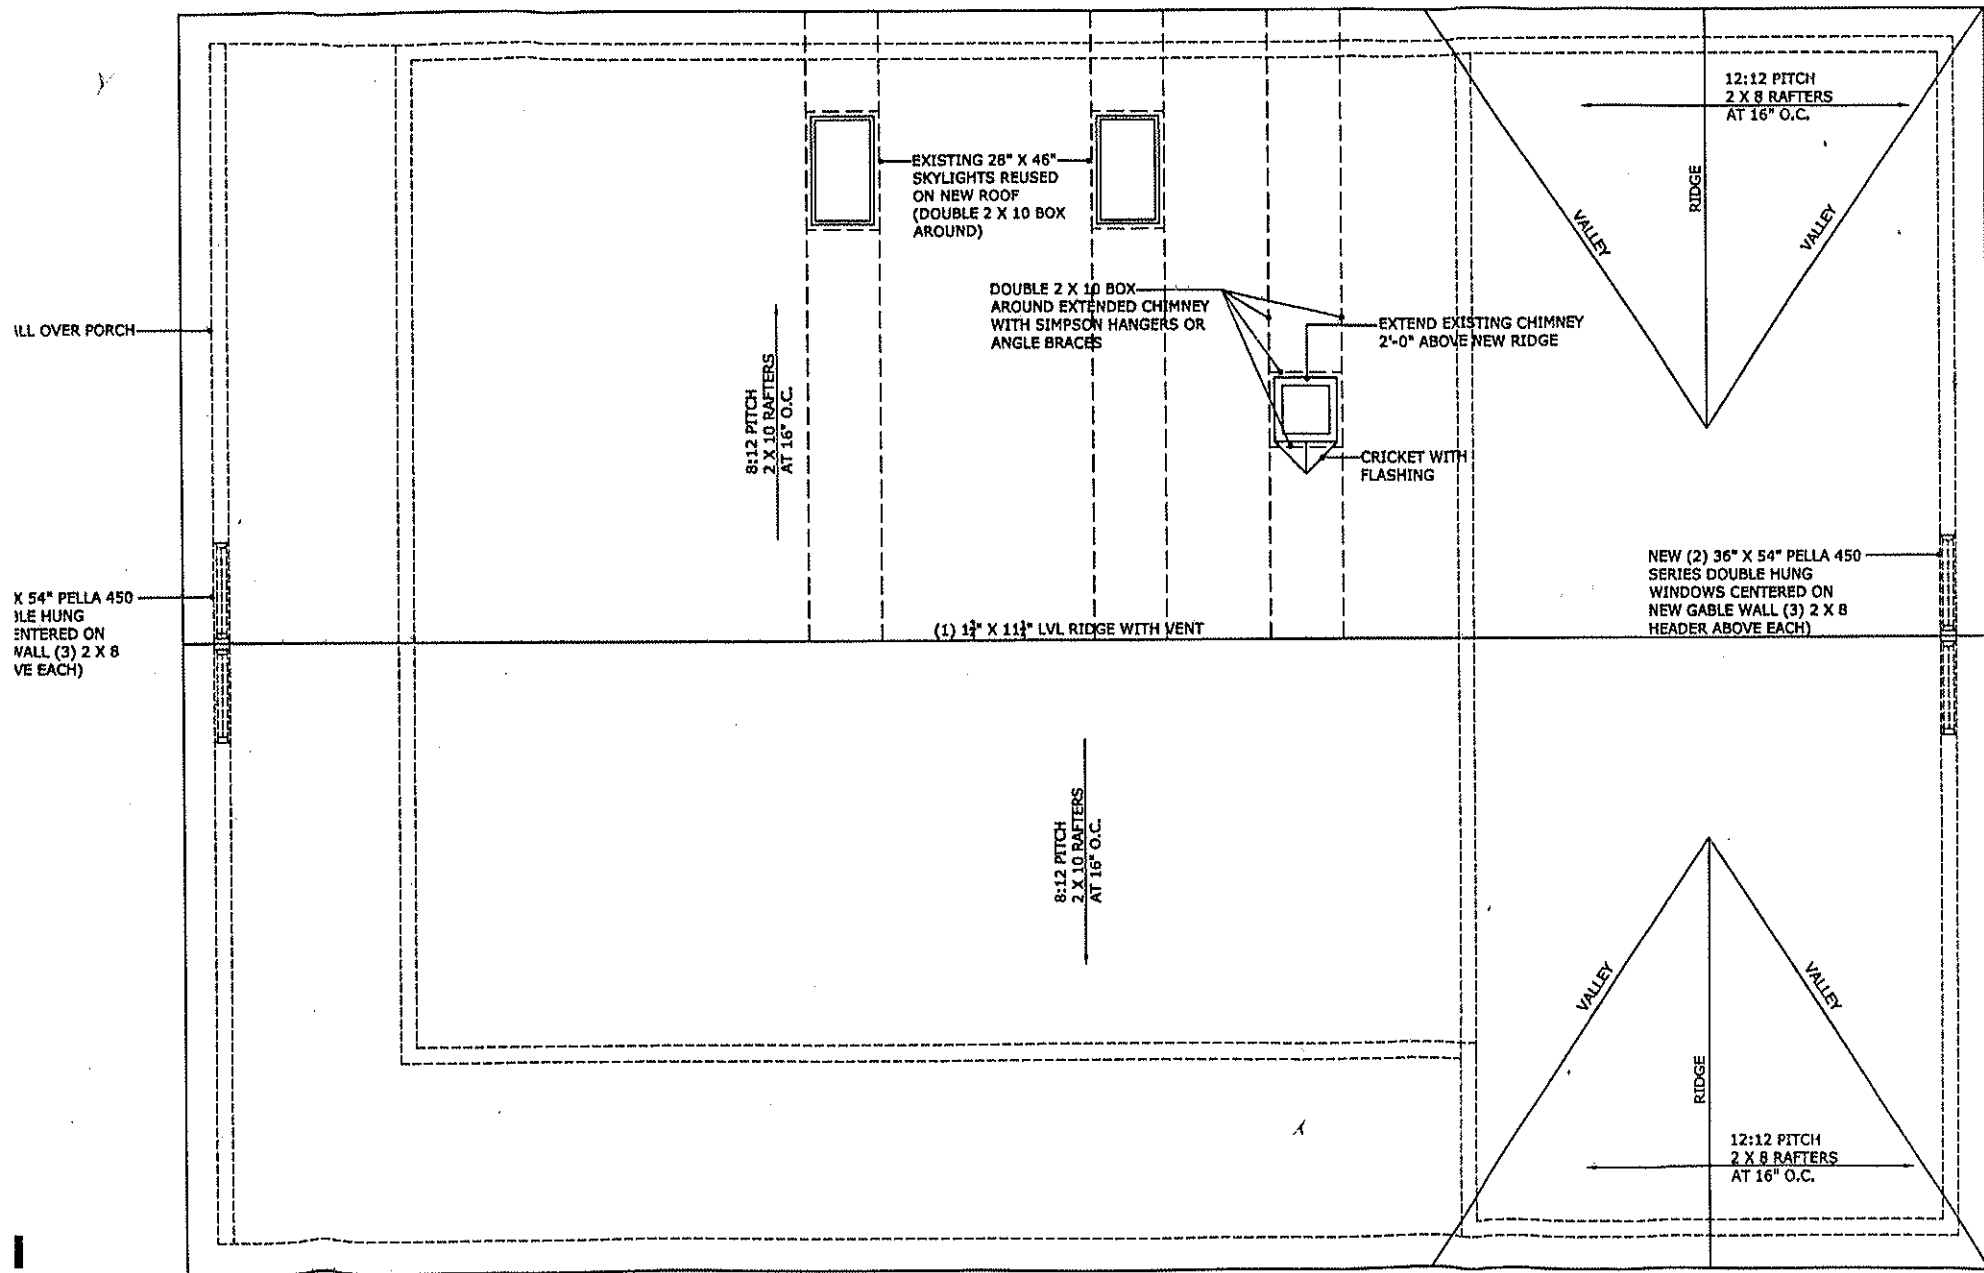

PLANS REVISED 8-18-2012 (AS-BUILT)